

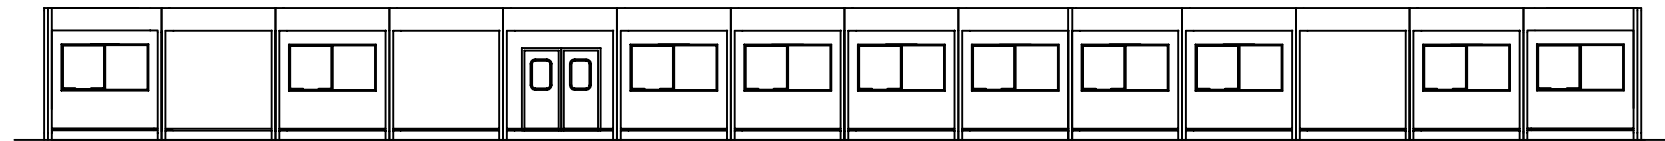


AS INSTALLED

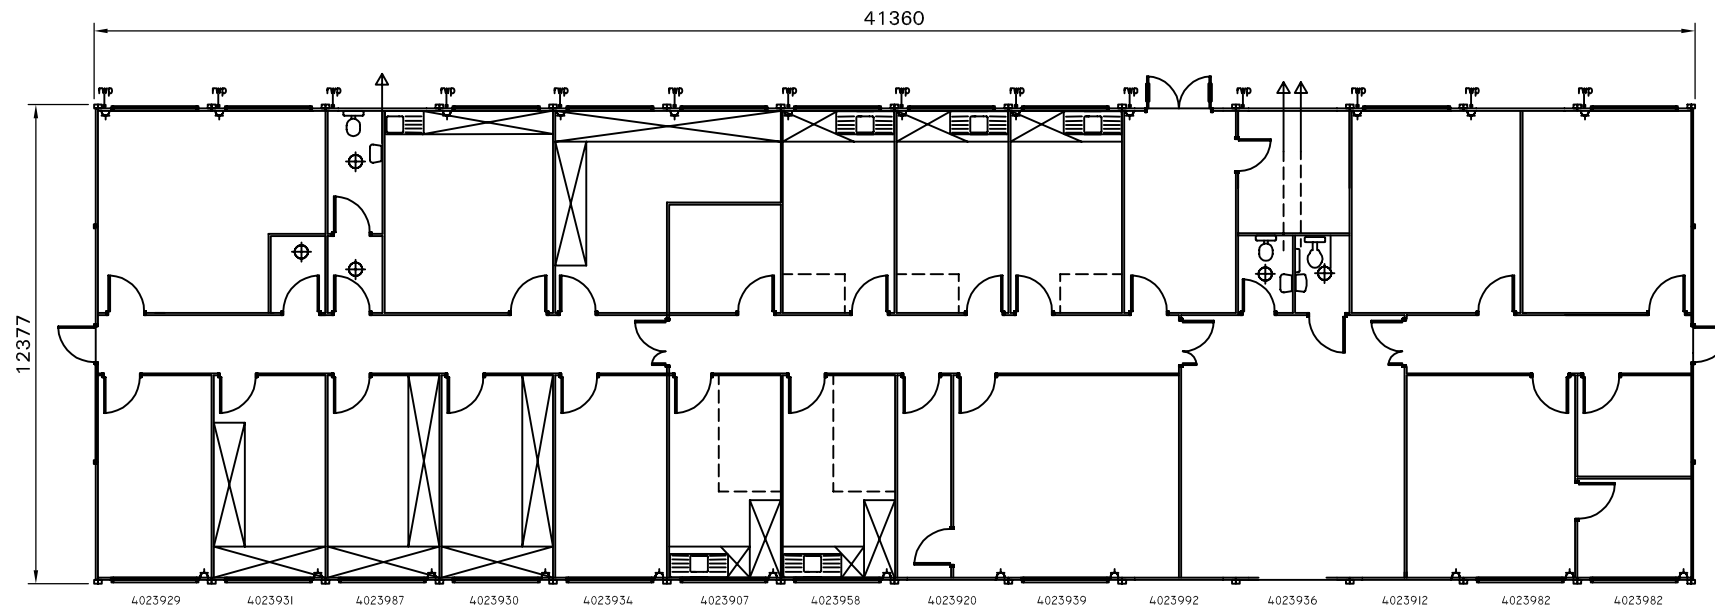

Rear Elevation

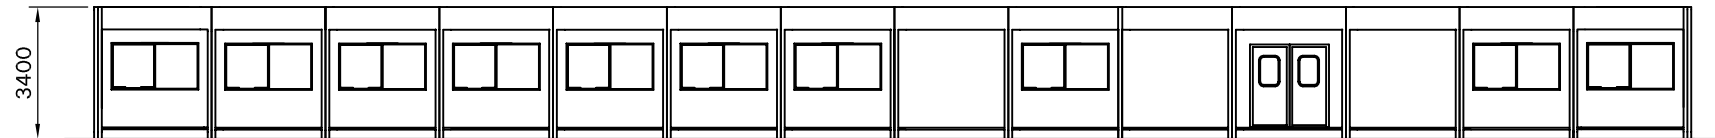

Surface au sol : 496,30 m<sup>2</sup>

**Duplex**  
 Building System

Portakabin Limited Huntington York YO32 9PT  
 Telephone 01904 611655 Fax 01904 611644

Project		AS INSTALLED Accommodation	
Client		Cedar House Investments	
Title		DX402 x 14 Modules	
Date	Drawn	Viki Webster	
Scale		1:100 @ A1	
Drg. No.	Rev.		